



PERMIT TO CONSTRUCT
Onsite Sewage Treatment and Disposal System

File Nbr: **2007110032**
County: Charleston

Name: ELEANOR GAVER

Type Facility: HOUSE

Subdivision:

Block: 4 BRM

Lot: A 1

Address: 38 S PORTLAND AVE
BROOKLYN, NY 11217

Site: 5753 CHURCH FLAT
MEGGETT, SC 29449

Program Code: 362

System Code: 240

TM#: 223-00-00-038

Water Supply: PRIVATE

PERMIT TO CONSTRUCT SYSTEM SPECIFICATIONS

Daily Flow (gpd): 480

LTAR: .60

Tank Sizes (gal): Septic Tank: 1000

Pump Chamber:

Grease Trap:

Trenches: Length (ft): 400 Width (in): 36 Max. Depth (in): 6

Agg. Depth (in): 6

Min Pump Capacity:

gpm at

ft. of Head


SPECIAL INSTRUCTIONS/CONDITIONS

THIS PERMIT IS SITE SPECIFIC. ANY CHANGES TO THE SYSTEM MUST BE APPROVED BY DHEC.
ANY UNAPPROVED CHANGES WILL VOID THIS PERMIT.

- ① DO NOT Drive or Park on Any Part of the System
- ② See Attached sheets.
- ③ keep System on Hill

PERMIT TO CONSTRUCT SYSTEM DIAGRAM

(NTS)

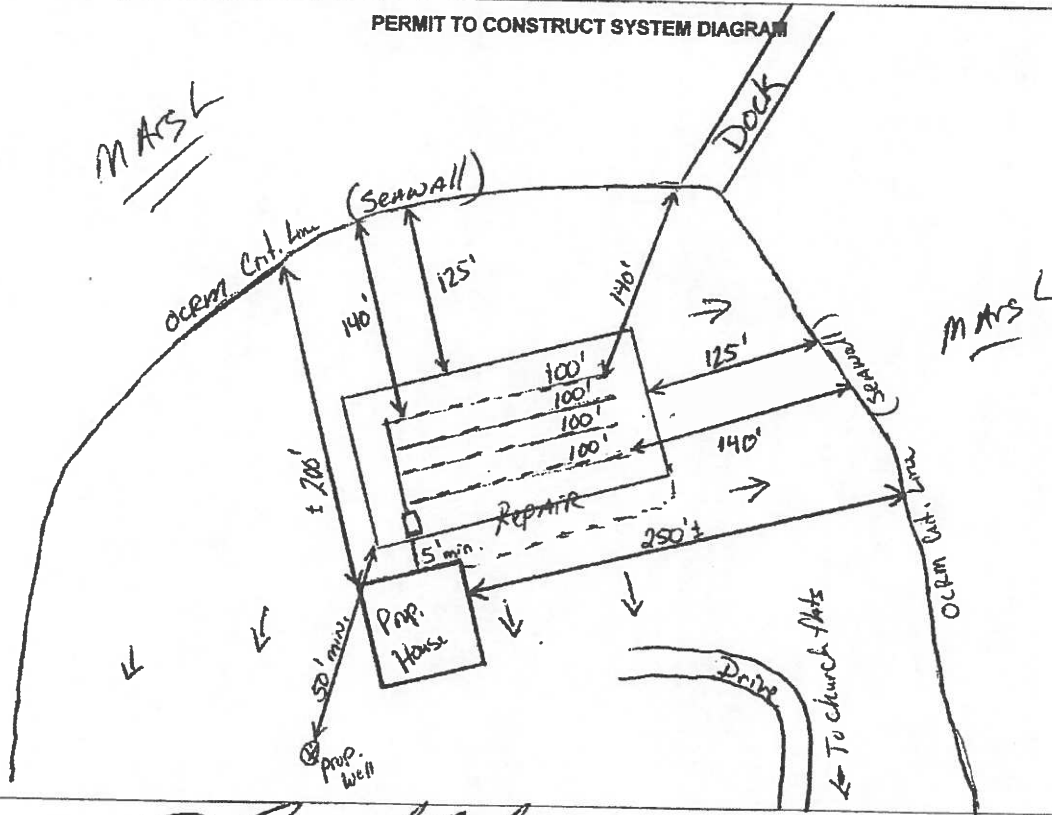

Issued/Revised By: *BL [Signature]*

Date: 12/28/07

DHEC 1768 (8/7/2006)

*Copies mailed
1-3-08*

This Permit is Appealable Under the Administrative Procedures Act.
This Permit will Expire and Become Null and Void Five (5) Years from the Issuance Date.