



OPERATIONS PERMIT


ON-SITE WASTEWATER SYSTEM TYPES II-V

14-061-JWCo.

APPLICANT/ OWNER	Donald Zachary	PERMIT #	14080100367
LOCATION	1049 Boulder Rd., YADKINVILLE, NC 27055		
DESIGN	25% Reduction	FACILITY	SFD
		WATER	Well
		INSTALL TYPE	Infiltrator 25% Red.

The following items are on file and part of this Permit: Application P/CA Soil Sheet Plat Map Engineer's Drawing

As-Built Diagram (Not to Scale)

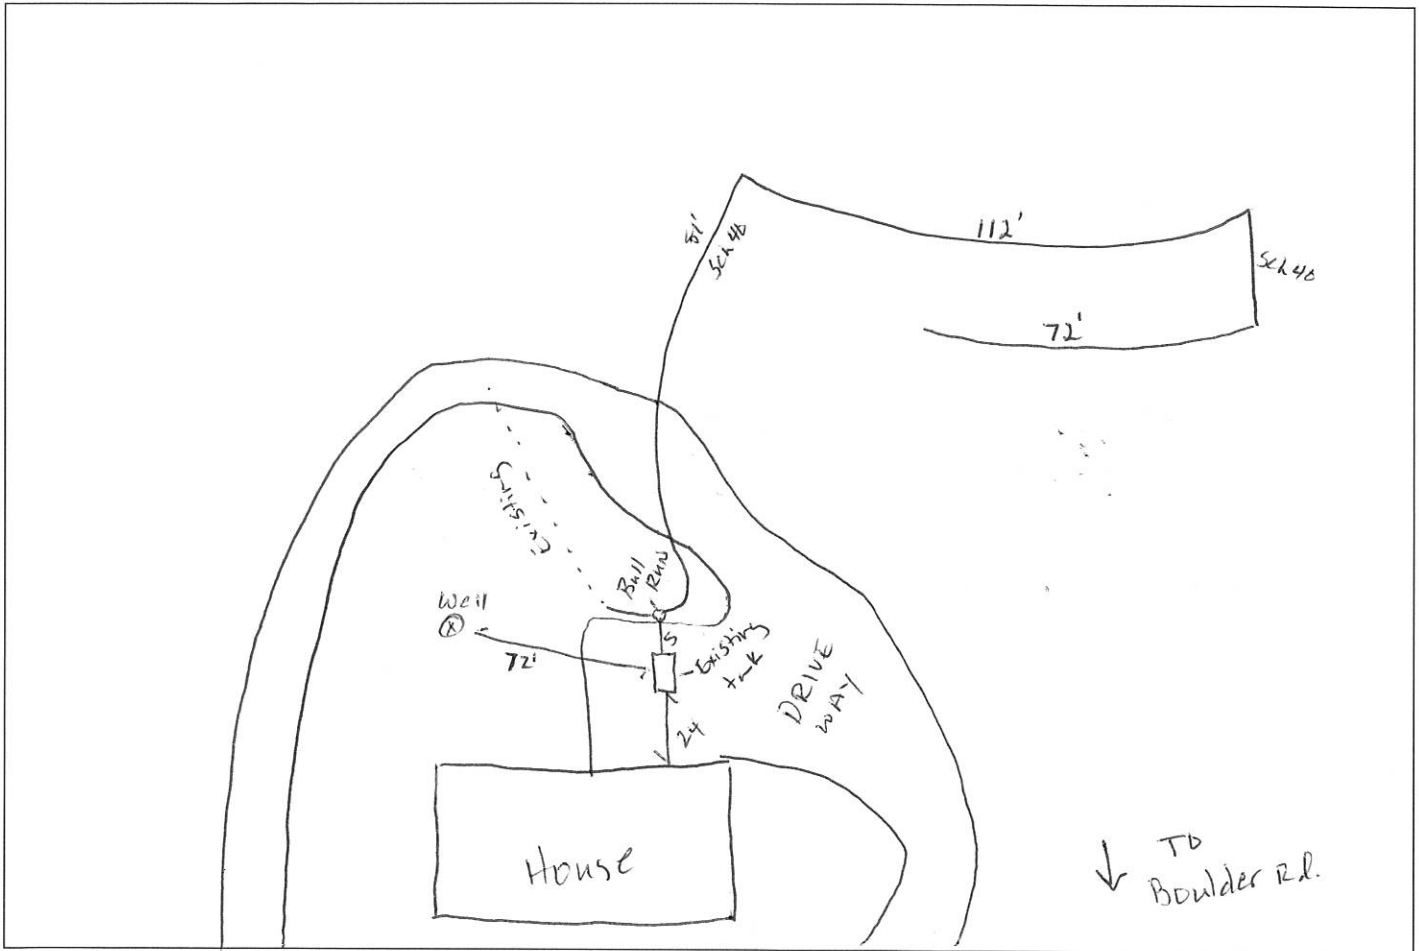

Initial System: Conv.	LTAR: —	# of Lines	Repair System: 25%	LTAR	—
Trench Depth: 36-48"	Cover Depth: 24-36"	Stone Depth: N/A	Linear Feet: 184'	# of Boxes: N/A	
S. Tank: Existing	Pump Tank: N/A				
Installer: Row Adams	Well Setback: 72"				
Comments: Original repair permit amended by S. Steed on 12/8/14					

This system has been installed in compliance with applicable NC General Statutes, Rules for Sewage Treatment and Disposal, and all conditions of the I.P. and A.C System shall perform in accordance with Rule. 1961. Ground absorption sewage treatment and disposal systems shall be checked, and the septic tank removed, periodically from all compartments, to ensure proper operation of the system. The contents shall be pumped whenever the solids level is found to be more than 1/3 of the liquid in any compartment. QUESTIONS? (336) 679-4244

Name, REHS# Scott Steed, REHS Authorized State Agent