



The Jackson County Department of Public Health  
538 Scotts Creek Rd. Suite 100 \* Sylva, NC 28779  
Tel: 828-586-8994 \* FAX: 828-586-3493  
Shelley Carraway  
DIRECTOR  
Shelley Carraway

### Improvement Permit

|  |  |
|--|--|
| <b>Reference Number:</b> 2023-24801-9-12848                    | <b>Permit Number:</b> 2023-24801-9-12848 |
| <b>PIN:</b> 7548-71-0172                                       | <b>Application Date:</b> 4/4/2023        |
| <b>Owner:</b> WINSLOW, CYNTHIA A                               | <b>City:</b> BAY VILLAGE OH              |
| <b>Address:</b> 586 REVERE DR                                  | <b>Zip Code:</b> 44140                   |
| <b>Lot Number:</b> TR L,M HIGHER GROUND GARDENS                | <b>Bedrooms:</b> 3                       |
| <b>Service Type:</b> IP  |  |
| <b>Directions To Site:</b> Pressley Creek Rd to Cabin Ridge Rd |  |

**Initial System Type: IIIG - 25% REDUCTION**

**LTAR: .5**

**Repair System Type: Drip Irrigation**

**Water Source: NOT APPLIED FOR**

**Remarks:** Attached drawing not to scale  
Do not excavate, fill or stump over proposed septic areas. Exact house and driveway shall be marked on the ground to scale prior to the issuance of a construction authorization. Maintain repair areas.

AREA FOUND TO SUPPORT A 3-BEDROOM RESIDENCE UTILIZING A IIIG- 25% REDUCTION TYPE SYSTEM FOR INITIAL AND DRIP IRRIGATION FOR REPAIR AREA.

SYSTEM ADEQUATE FOR 3 BEDROOMS 360 GPD MAXIMUM OCCUPANCY 6 PEOPLE.

THIS PERMIT EXPIRES ON: 4/17/2028.

**Fee:** \$360.00

**Receipt:** \_

**EHS:** *Dana Madley, REHS #3113*

**Date:** *4/17/2023*

**Signature:** *Emailed to J.*


**Date:** *4/17/23*



Jackson County Department of Public Health  
538 Scotts Creek Road, Suite 100  
Sylva, NC 28779  
Phone: (828) 587-8250 FAX: (828) 586-1207

# Improvement Permit

|                     |                                     |                   |                    |
|---------------------|-------------------------------------|-------------------|--------------------|
| Reference Number:   | 2023-24801-9-12848                  | Permit Number:    | 2023-24801-9-12848 |
| PIN:                | 7548-71-0172                        | Application Date: | 4/4/2023           |
| Owner:              | WINSLOW, CYNTHIA A                  | City:             | BAY VILLAGE OH     |
| Address:            | 586 REVERE DR                       | Zip Code:         | 44140              |
| Lot Number:         | TR L,M HIGHER GROUND GARDENS        | Bedrooms:         | 3                  |
| Service Type:       | IP                                  |                   |                    |
| Directions To Site: | Pressley Creek Rd to Cabin Ridge Rd |                   |                    |

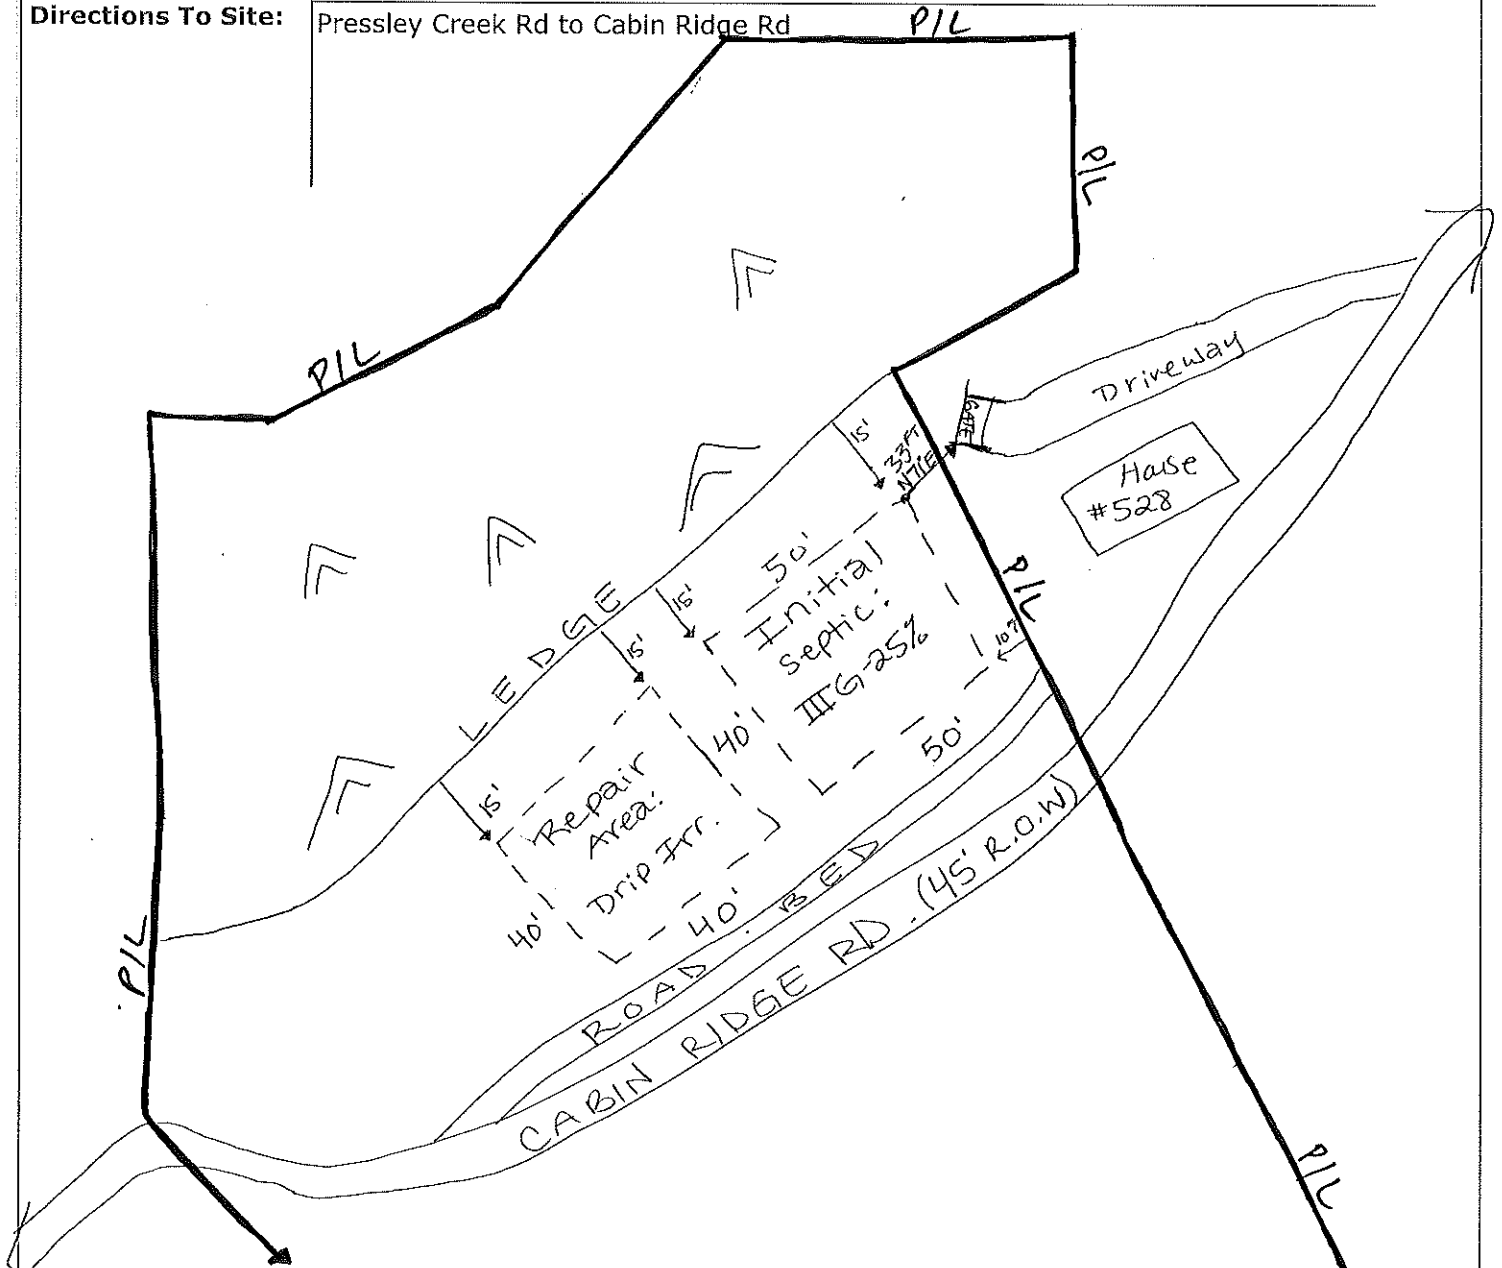

Fee: \$360.00

Receipt: -

EHS: Dana Madej, REHS 3113

Date: 4/17/2023

Signature: Emanted to [initials]

Date: 4/17/23