

**YADKIN COUNTY ENVIRONMENTAL HEALTH**

SEPTIC TANK SYSTEM LAYOUT/DESIGN       WELL LOCATION

PERMIT # 05080102397      NAME Thyra Wagoner      DATE 7-20-05


**STS SPECS**

NEW INSTALLATION \_\_\_\_\_ REPAIR  LTAR \_\_\_\_\_  
SYSTEM TYPE conv. CLASS \_\_\_\_\_ REPAIR TYPE \_\_\_\_\_ CLASS \_\_\_\_\_  
SEPTIC TANK EXISTING (gal) LINEAR FT 200 TRENCH DEPTH 36"  
PUMP TANK \_\_\_\_\_ (gal) STONE DEPTH 18" COVER DEPTH 18"  
INSTALLER: T. Pixon NO. BOXES 1 NO. LINES 1

**WELL INFO**

- NEW WELL       REPLACEMENT WELL       WELL FOR SINGLE RESIDENCE  
 WELL FOR 2 OR MORE RESIDENCES       PRIVATE WELL       PUBLIC WELL

↑ well at chicken house

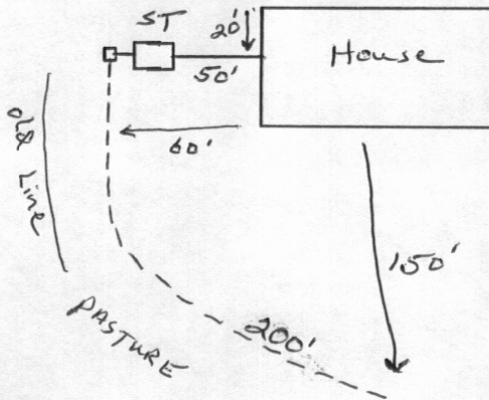

COMMENTS: \_\_\_\_\_

BY: Mike Wilham \_\_\_\_\_ EHS/RS