

**Wastewater Treatment System Permit Application**

**Teton County\***       **Pondera County**

(Please complete and submit to the Sanitarian's office or schedule a meeting for assistance)

Owners Name: RANDOLPH L. HENRY Phone: 406-467-2781 (required)  
 Owners Address P.O. BOX 324, FAIRFIELD, MT 59436  
 Physical Address of Site: 1095 3RD ROAD NE, POWELL, MT 59468  
 General Area Name: FAIRFIELD BENCH  
 Geocode # 31-3253-17-4-01-03-0000 Tax ID # \_\_\_\_\_  
 Location of Installation: WS 1/2 SESE Section 17, T 22 N R 01 W  
 Certificate of Survey: # 655 Subdivision: TRACT A2  
 Lot: \_\_\_\_\_ Block: \_\_\_\_\_ Tract: A2 Size of Parcel: 10 ACRES File #: \_\_\_\_\_

Separation Adequate For: (info provided by applicant)	YES	NO
Wells > 100 feet	✓	
Water Lines > 10 feet	✓	
Floodplain > 100 feet	✓	
Surface Water > 100 feet	✓	
High groundwater > 4 feet	✓	
Bedrock > 4 feet	✓	
Slope < 15 %, Engineer 15 -25%	✓	
Property Lines, Buildings > 10 feet	✓	

Special Conditions and Other Information	YES	NO
Sanitary Restrictions		✓
Any Existing Systems?		✓
Upgrade Required?		✓
Inside or near Floodplain?		✓
Public Sewer less than 200 feet?		✓

Soil type: Silty Clay loam / Clay loam NRC5 soils info  
 Water Supply: Well

\*For new construction, please include a copy of the water analysis report (Total Nitrate + Nitrite)

Type of System to be Installed: New \_\_\_\_\_ Replacement YES

System Sizing: \_\_\_\_\_ Residential # of Bedrooms: 4 Gal/Day: 350  
 Basement: Yes No 3-Home 1-Guest room in wood shop  
 \_\_\_\_\_ Commercial Use: \_\_\_\_\_ Gal/Day: \_\_\_\_\_

Application rate (gal/day or sq. ft./bedroom): 0.3

From plat approval ✓; Site evaluation ✓; Engineer \_\_\_\_\_  
 System Size & Description: 2-1000 Gallons ( x concrete; \_\_\_\_\_ other, specify) septic tank 1-Home 1-Woodshop w/guest room  
 with 360 lineal feet of x 24-inch or \_\_\_\_\_ 36-inch trench drainfield as per site plan attached.

Justification for system proposed: Existing drainfield under driveway - at this time the Henry's wanted to build woodshop w/ restroom

Special Conditions: best solution - abandon existing drainfield & install new drainfield to accommodate both home & shop

The system does not meet minimum standards for subdivision and may limit ability of the owner to subdivide the property. YES \_\_\_\_\_ (Explain): \_\_\_\_\_

As permit applicant, I agree to comply with all requirements for installation as described in the county regulations and conditions on the permit. The permit is valid for twelve (12) months from date of purchase. The wastewater treatment system must be completed and connected to a structure within this time and inspected by the county prior to covering the system. A copy of the permit must be on site at all times during construction and inspection of the system and a completed permit must be submitted to the Sanitarians office.

Applicant: Randolph L. Henry Date: 7-22-13  
 Relationship to Property Owner: SELF

\* Fees must be paid to Teton County before a permit is issued (\$25 plus mileage round trip to site from Choteau calculated using current State mileage rate) Amount: \$ 59.90 Ck # 1044 Date: 7-22-13

*pd 7-22-13  
# 1044*


## Wastewater Treatment Lot Layout

Method used for nonsignificance determination pursuant to Water Quality Act and ARM 17.30. 701 et al:

*N/A - Replacement SS*

Provide drawing of system below or attach drawing that includes the following: property lines, existing and proposed structures, including basements, all existing and proposed wells within 100 feet of the wastewater system, all streams, lakes, springs, ponds, irrigation ditches, 100-year floodplain, floodway, driveways and parking areas, utility lines, existing wastewater systems, a legend and scale, direction of slope, percent slope, north directional arrow, plan for proposed wastewater treatment system and replacement area, mixing zones, and any other applicable information.

North ↑

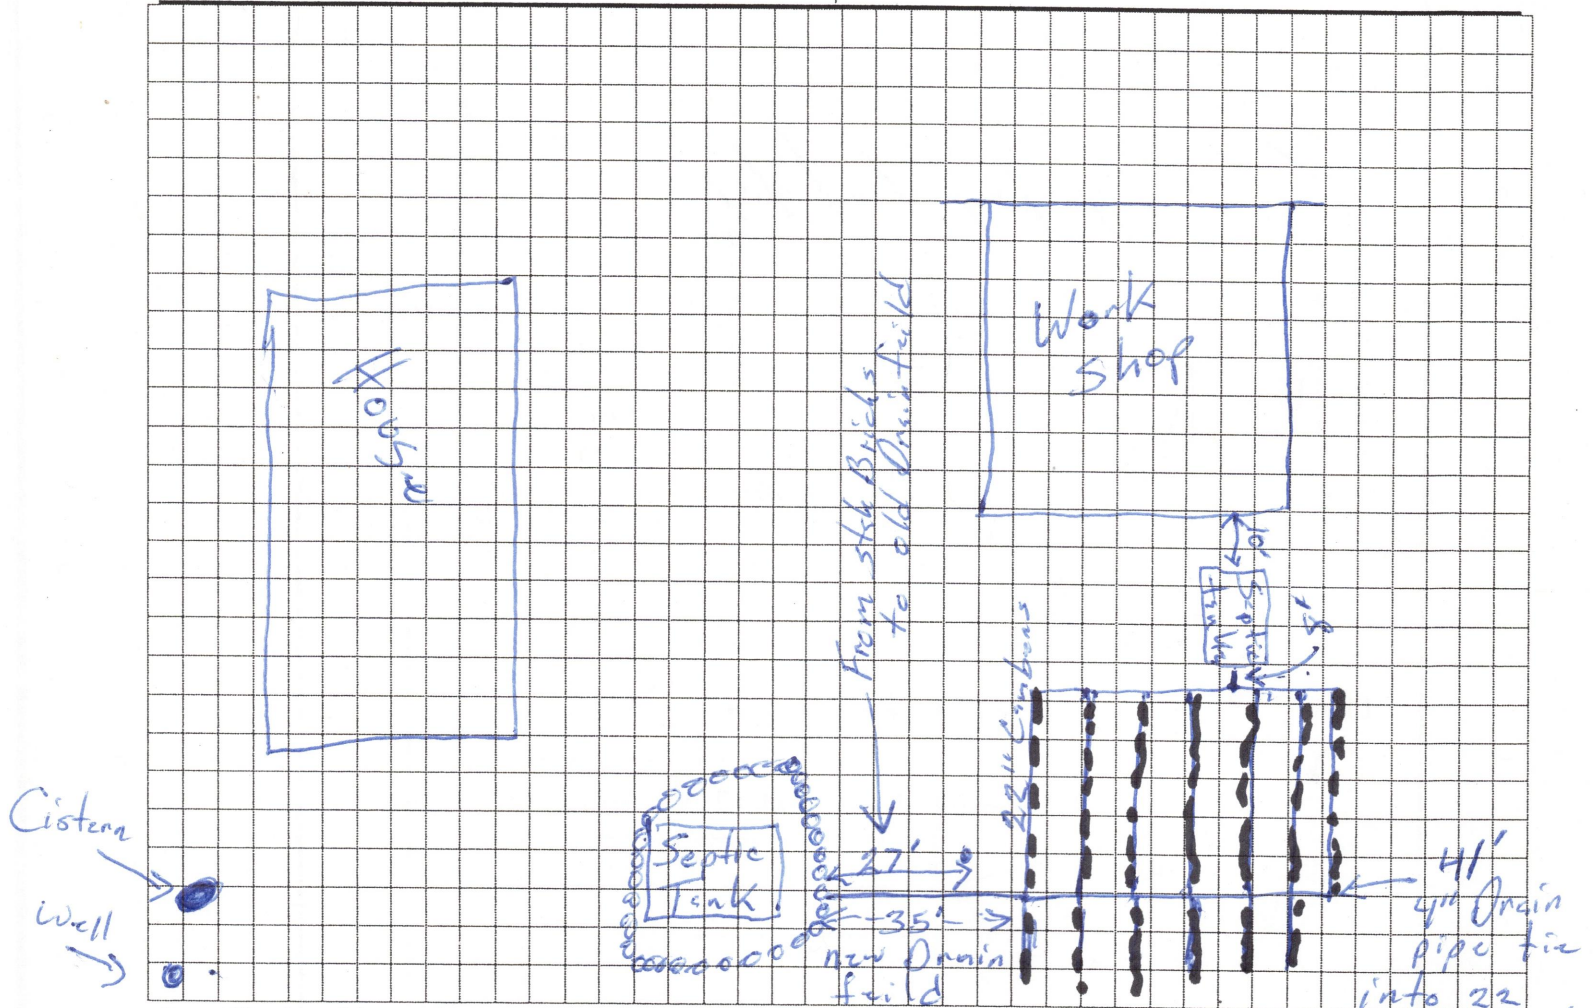

I certify that this septic system has been installed according to current septic system regulations for Chamber,

Teton County     Pondera County

Installers Name: Reverse HC Excavating    Phone # 406-727-1961

Signature: [Signature]    Date: July 22, 2013

Relationship to Property Owner: none

Plan Approved By: Corrine a Rose RS    Date: June 4, 2013

Installation Inspected By: Corrine a Rose RS    Date: July 22, 2013

Corrine Rose, Co. Sanitarian	Teton Co. Mon. and Tues. 466-2150 Pondera Co. Wed & Thurs. 271-4056	E-mail: <a href="mailto:crose@3rivers.net">crose@3rivers.net</a> Cell phone: 868-7935
------------------------------	------------------------------------------------------------------------	------------------------------------------------------------------------------------------