

WASCO-SHERMAN PUBLIC HEALTH DEPARTMENT

419 East Seventh, Room 100

The Dalles, OR 97058

(541) 296-4636

Application for:
Evaluation \_\_\_\_\_ New Installation \_\_\_\_\_
Repair 2400 Other \_\_\_\_\_

Wasco County
Date Pd: Eval \_\_\_\_\_ Permit \_\_\_\_\_
Other \_\_\_\_\_

Permit Number \_\_\_\_\_
Date Issued \_\_\_\_\_

Eugene A. Gravel
(Name of Applicant)

X Township 15 Range 12 Section 190

2512 SE Norelius Dr
(Mailing Address)

Tax Lot # 4803 4100
(This information may be obtained from Tax Assessor's office or your property tax statement.)

Vancouver Wa 98683
(City) (State) (Zip)

Proposed use:
Residential [ ] Commercial [ ]
Other (explain) \_\_\_\_\_

360-892-7352
(Telephone)

Water Supply: Community \_\_\_\_\_ Private: Well X Spring \_\_\_\_\_

DIRECTIONS TO PROPERTY: (Please be specific.)

Physical address 6289 upper 5-mile
the Dalles, OR
approximately 2 1/2 miles from downtown the Dalles, out 197, out 5 mi road
to the house.
Follow 197 over the first hill turn Rt onto 5 mi Rd. App 1/2 mi turn left onto
5 mi Rd (The dump is above you on the Rt.). App. 3 mi to next junction, go straight
following Pleasant Ridge/ 5 mi rd. App 3 mi to next junction go right staying
on 5 mi. App 5 mi to next junction, turn left staying on Upper 5 mi don't
follow Dutch Flat ripon. App 5 mi to next junction turn left crossing bridge.
About 1/2 mi you will see private drive ripon on your left. This is entrance to property.

Property Zone A-1 Agricultural / Timber Size of lot or parcel Appx 7d.8 AC

Test Holes [ ] have been prepared [ ] will be prepared (date) \_\_\_\_\_

X Eugene A. Gravel
(Signature Owner/Installer)

4-19-2000
(Date)

IMPORTANT: ATTACH A MAP OF PROPERTY INCLUDING LOCATION OF WELL; ANY WELLS ON ADJACENT PROPERTY, AND TEST HOLES. ON LOTS LESS THAN 20 ACRES, APPROXIMATE PROPERTY CORNER SHOULD BE VISIBLY MARKED.

01/05/00 1000 gal tank min
300 feet of standard

60224

Control No.

STATE OF OREGON DEPARTMENT OF ENVIRONMENTAL QUALITY

PERMIT NO. 33-020R Mej

\$ 240 major Fee

New Construction Repair Other

Permit Issued To Eugene Gravel (Property Owner's Name) 18 (Township) 12 (Range) 19 (Section) Wasco (Tax Lot / Acct. No.) (County)

Upper Five Mile (Road Location) The Dalles (City) [Signature] (Issued by - Signature) 4-19-00 (Date Issued)

PERMITS ARE NOT TRANSFERABLE

ALL WORK TO CONFORM TO OREGON ADMINISTRATIVE RULES, CHAPTER 340. WORK SHALL BE DONE BY PROPERTY OWNER OR BY LICENSED SEWAGE DISPOSAL SERVICE. (MAKE NO CHANGES IN LOCATION OR SPECIFICATIONS WITHOUT WRITTEN APPROVAL)

SPECIFICATIONS

EXPIRATION DATE 4-19-01 TYPE OF SYSTEM Standard

Design Sewage Flow 450 Gallons/Day

Tank Volume 1000 min. Gallons Disposal Trenches Seepage Bed(s) Square Feet

Maximum Depth 36 inches. Minimum Depth 24 inches. 300 Linear Feet min.

Equal Loop Serial Pressurized Minimum Distance Between Trenches 8 feet

Total Rock Depth 12 inches. Below Pipe 6 inches. Above Pipe 2 inches. Rake Sidewall

Special Conditions (Follow Attached Plot Plan)

PRE-COVER INSPECTION REQUIRED - CONTACT 296 4636

CERTIFICATE OF SATISFACTORY COMPLETION

As-Built Drawing with Reference Locations

Installer Self

Final Insp. Date

Inspected By [Signature]

Issued by Operation of Law

Pre-cover inspection waived pursuant to OAR 340, Division 71


Grid area containing handwritten text: See Attached Sketch

In accordance with Oregon Revised Statute 454.665, this Certificate is issued as evidence of satisfactory completion of an on-site sewage disposal system at the location identified above.

Issuance of this Certificate does not constitute a warranty or guarantee that this on-site disposal system will function indefinitely without failure.

John Zaloznik (Authorized Signature) Sanitarian (Title) 11/13/00 (Date) WSPAD (Office)

Eugene Gravel  
15 12E 19 4803  
11/13/00

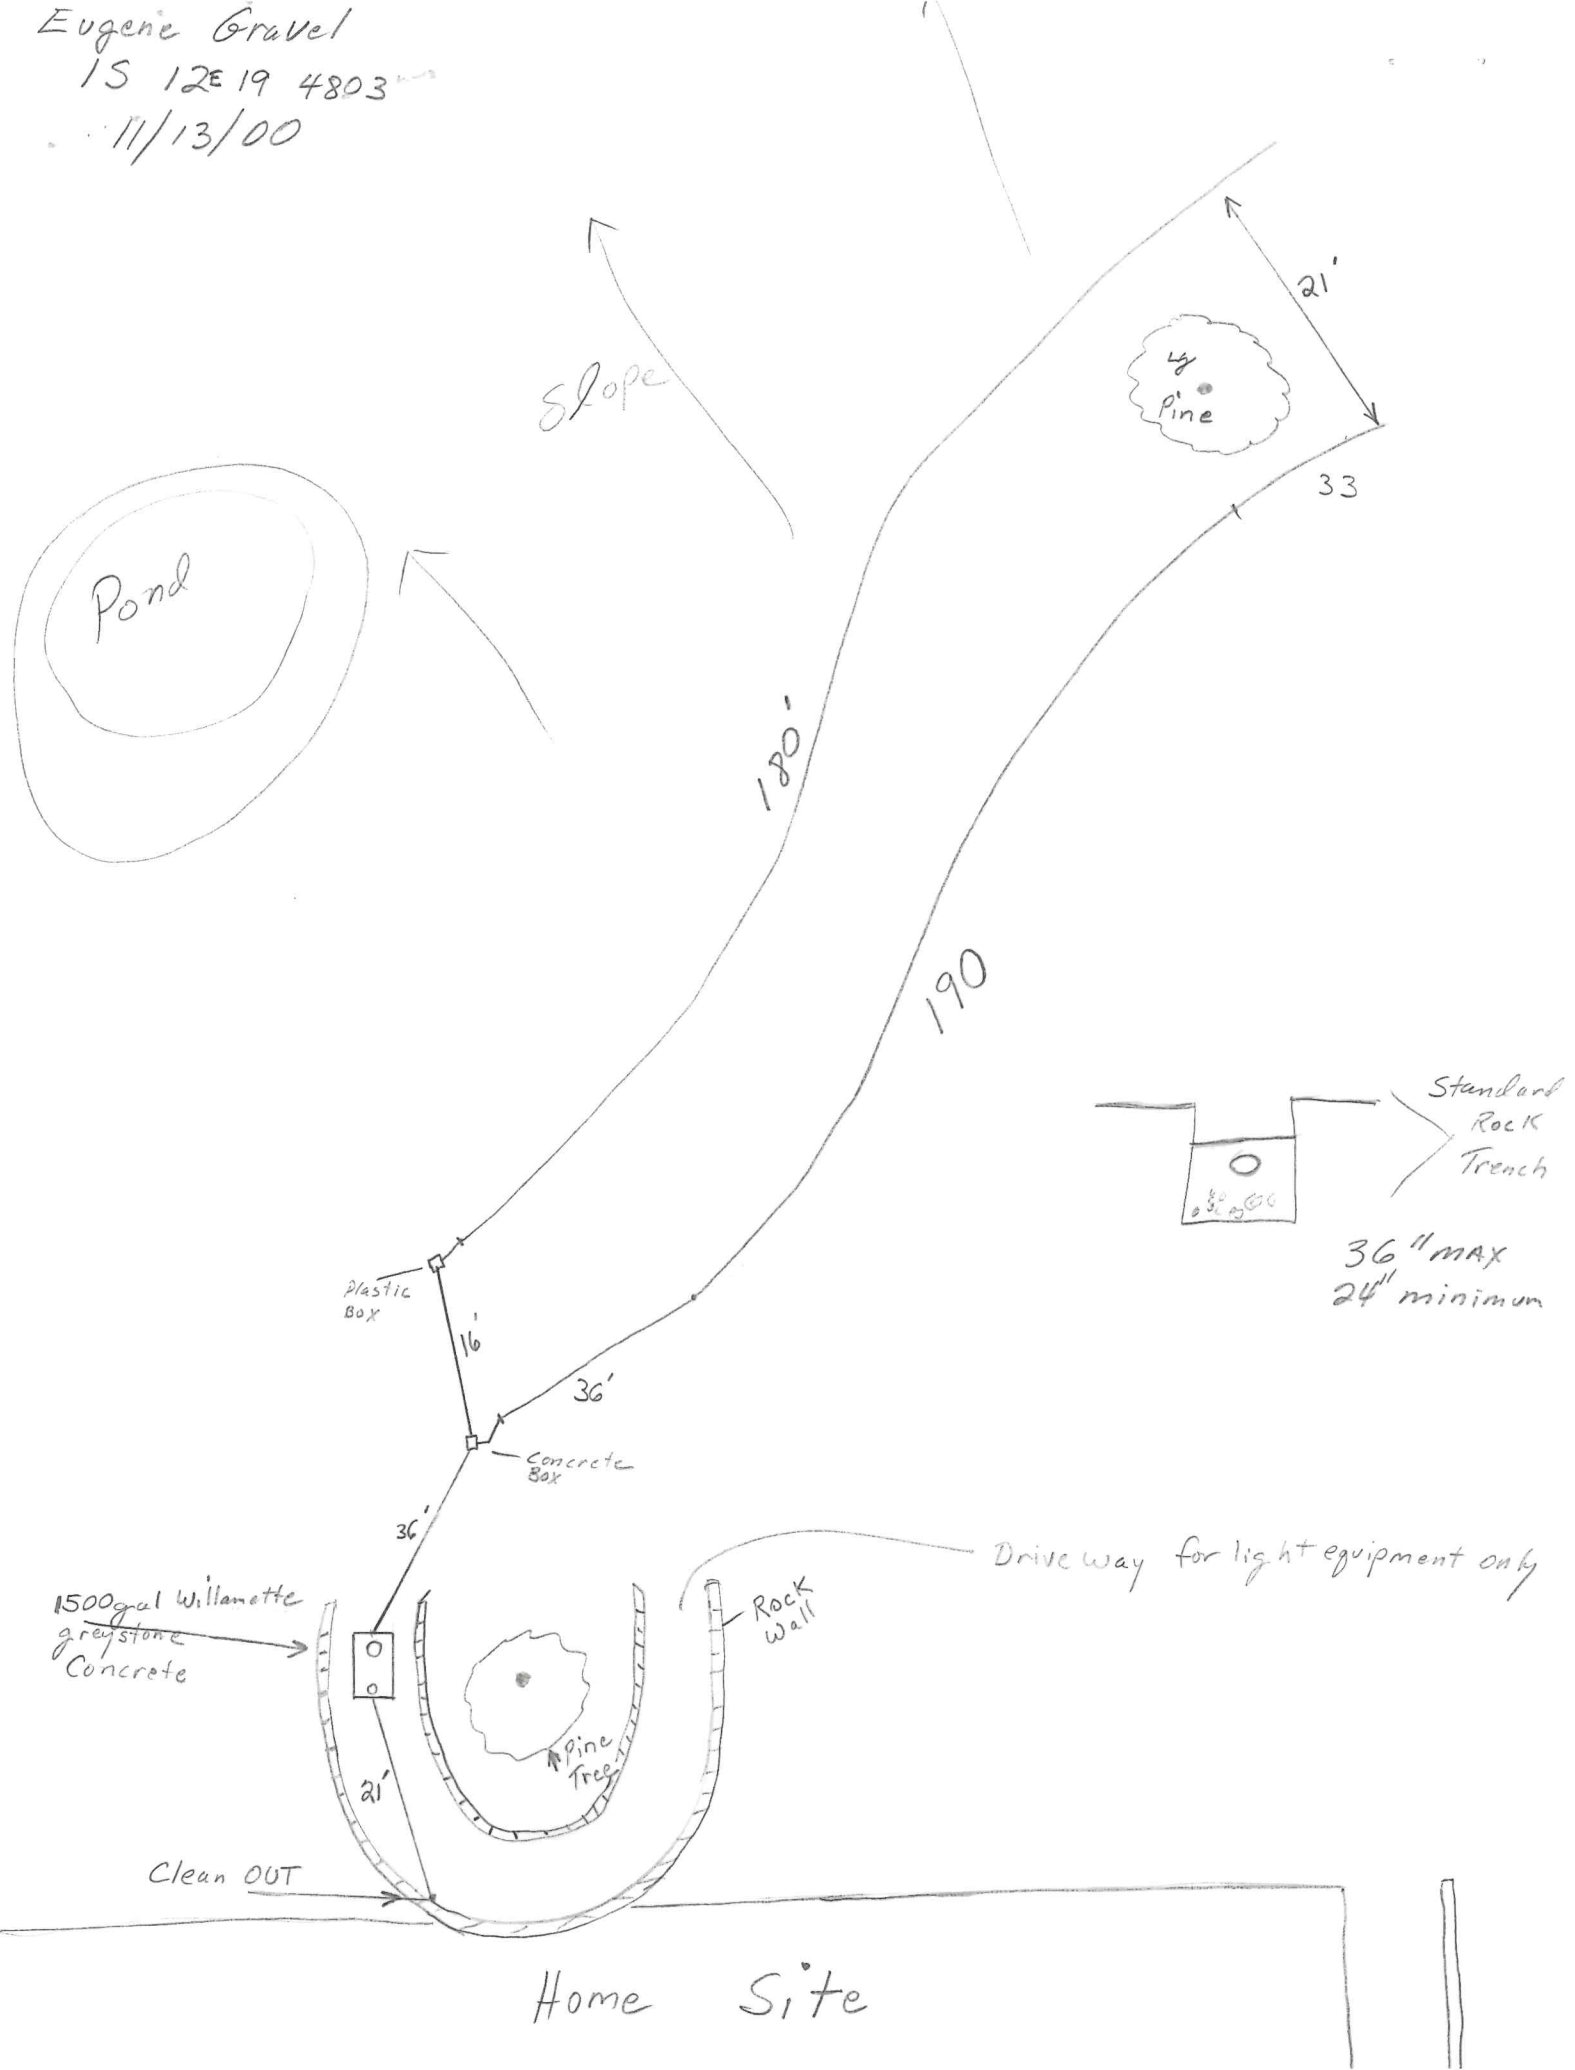

# FINAL INSPECTION REQUEST AND NOTICE


Pursuant to the requirements within ORS 454.665, OAR 340-71-170 and OAR 340-71-175, the system installer and/or the permittee must notify the Department of Environmental Quality (or its authorized Agent) when the construction, alteration or repair of a system for which a permit was issued is completed (except for the backfilling or covering of the installation). The Department (or Agent) has 7 days to perform an inspection of the completed construction after the official notice date, unless the Department (or Agent) elects to waive the inspection and authorizes the system to be backfilled earlier. Receipt and acceptance of this completed form by the Department (or Agent) establishes the official notice date of your request for the pre-cover inspection. Please complete all four sections of the form and return it to the office that issued the permit. Forms that are determined to be incomplete will be returned.

## SECTION 1: BASIC INFORMATION.

Property Owner Eugene, Lorraine Gravel Permit Number 33-020RM County Wasco  
Township W 1/2 1S; Range S 1/4 12 E; Section 19; Tax Lot 4803; Tax Acct. # 8789 2000  
Job Location 6289 Upper 5-mile Rd The Dalles, Ore  
Date System Construction Completed Nov 13, 2000; Date Submitted to DEQ or Agent Nov 13, 2000


## SECTION 2: MATERIALS LIST. Identify and list all materials used in the system's construction.

septic tank 1500 Gal concrete  
Drain Rock 1/2 conc about 37 cy's  
4" Drain pipe 390 LF  
2 ea Distribution boxes, one concrete, one plastic  
Filter Fabric over Drain Rock Typar filter fabric 36" x 300' per roll

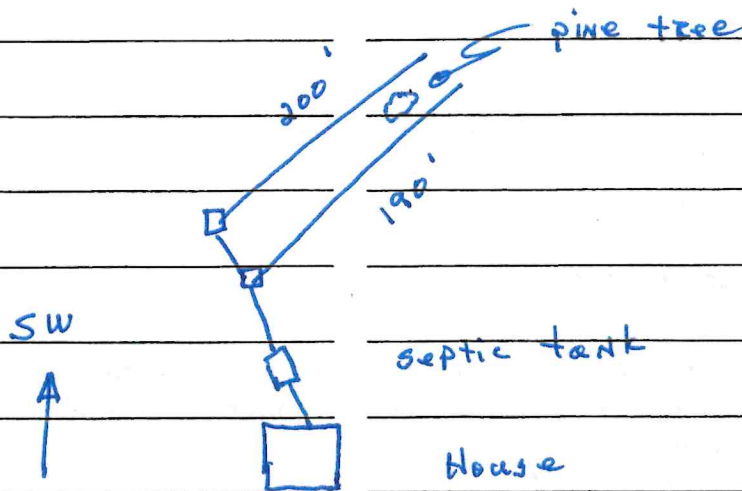

Property Owner Eugene Lorraine Gravel Permit Number 33-020RM County Wasco

**SECTION 3: AS-BUILT PLAN OF THE CONSTRUCTED SYSTEM.** Indicate the direction of NORTH and show the locations of all wells within 200 feet of the system.

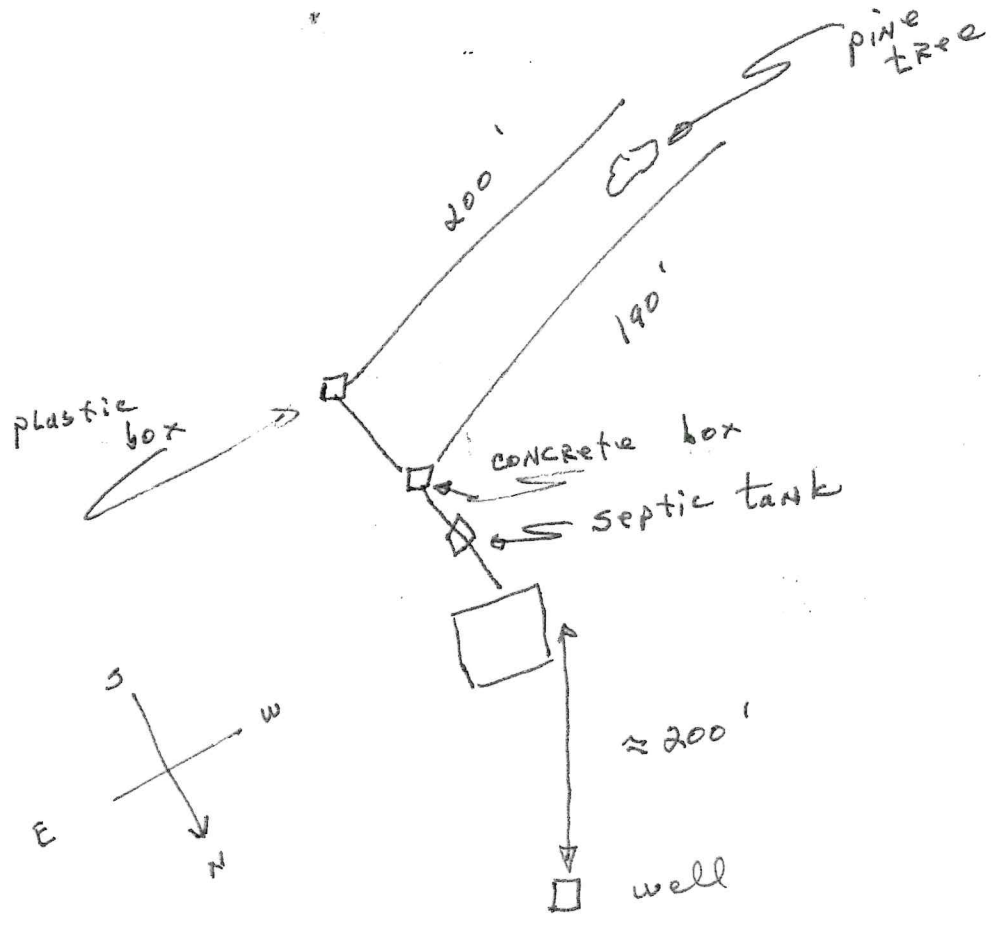

**SECTION 4: CONSTRUCTION WAS PERFORMED BY:**

\_\_\_\_ Property Owner (Permittee)

\_\_\_\_ Sewage Disposal Service Business: \_\_\_\_\_, \_\_\_\_\_  
(Print Full Business Name) (License Number)

I certify the information provided in this notice is correct, and that the construction of this system was in accordance with the permit and the rules regulating the construction of on-site sewage disposal systems (OAR Chapter 340, Divisions 71 and 73).

Eugene A. Gravel, Owner, 11-21-00  
(System Installer's Signature) (Title) (Date)