


SURRY COUNTY HEALTH AND NUTRITION CENTER

Operations Permit



Applicant's Name: Rick Poindexter PIN: 5935-00-82-5804 Permit Number:  
 Site Address: 3225 NC 268  
 Subdivision: Lot Number:  
 Directions to Site: Hwy 268 W from Pilot Mtn, site on L.  
 OP Issued by: Johnny Easter Date Issued: 03/27/2007  
 Authorized State Agent:  
 Septic Contractor:  
 IPVCA Issued by: Michael Merzell Date Issued: 07/09/2006

NC 268  
 → To Pilot Mtn

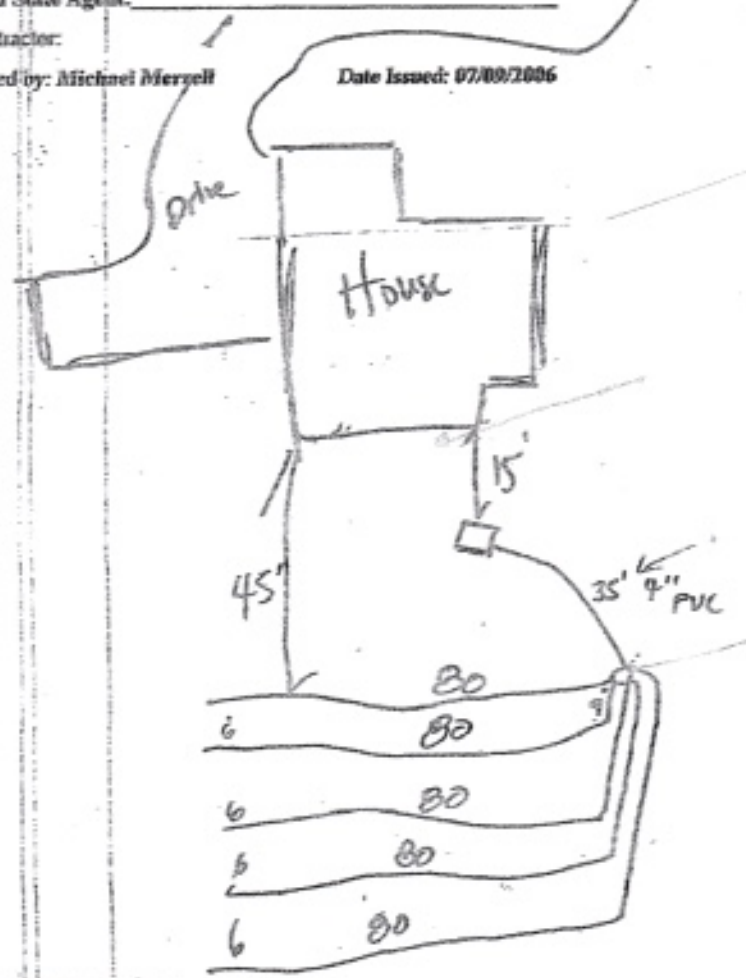

SYSTEM SPECIFICATIONS

Facility Type: SFD  
 Daily Design Flow: 480 GPD  
 Number of Bedrooms: 4  
 Initial System Type: 25% reduction Initial LTAR: 0.3 Repair System Type: Repair LTAR:

New  Expansion  Repair  
 Number of People: Number of Occupants:  
 (Members/Employees) Type of Water Supply:

TANK INFORMATION

Septic Tank ID: CRS YAd 1069 ST 620 Liquid Capacity: 1060ga Date of Manufacture: 12/8/06  
 Pump Tank ID: Liquid Capacity: ga Date of Manufacture: / /  
 Filter Type:

NITRIFICATION FIELD

Total Trench Length: 480 feet Trench Depth: inches Trench Width: 36 inches  
 Aggregate Depth: inches Trench Spacing: 9+ feet on center

PUMP SPECIFICATIONS

Total Length of Supply Line: feet TDH: feet Discharge Volume: gallons  
 Diameter of Supply Line: inches Draw Down: inches Anti-siphon Hole:  yes  no  
 Vent Hole:  yes  no Valves Accessible:  yes  no Check Valve:  yes  no Ball/Gate/Globe Valve:  yes  no  
 Threaded Union:  yes  no Rope or Stainless Steel Chain:  yes  no Alarm Audible & Visible:  yes  no  
 NEMA 4X box (or equivalent): in. above finished grade Riser: in. above finished grade